


Notes:

1. All sizes are correct to nearest 5mm

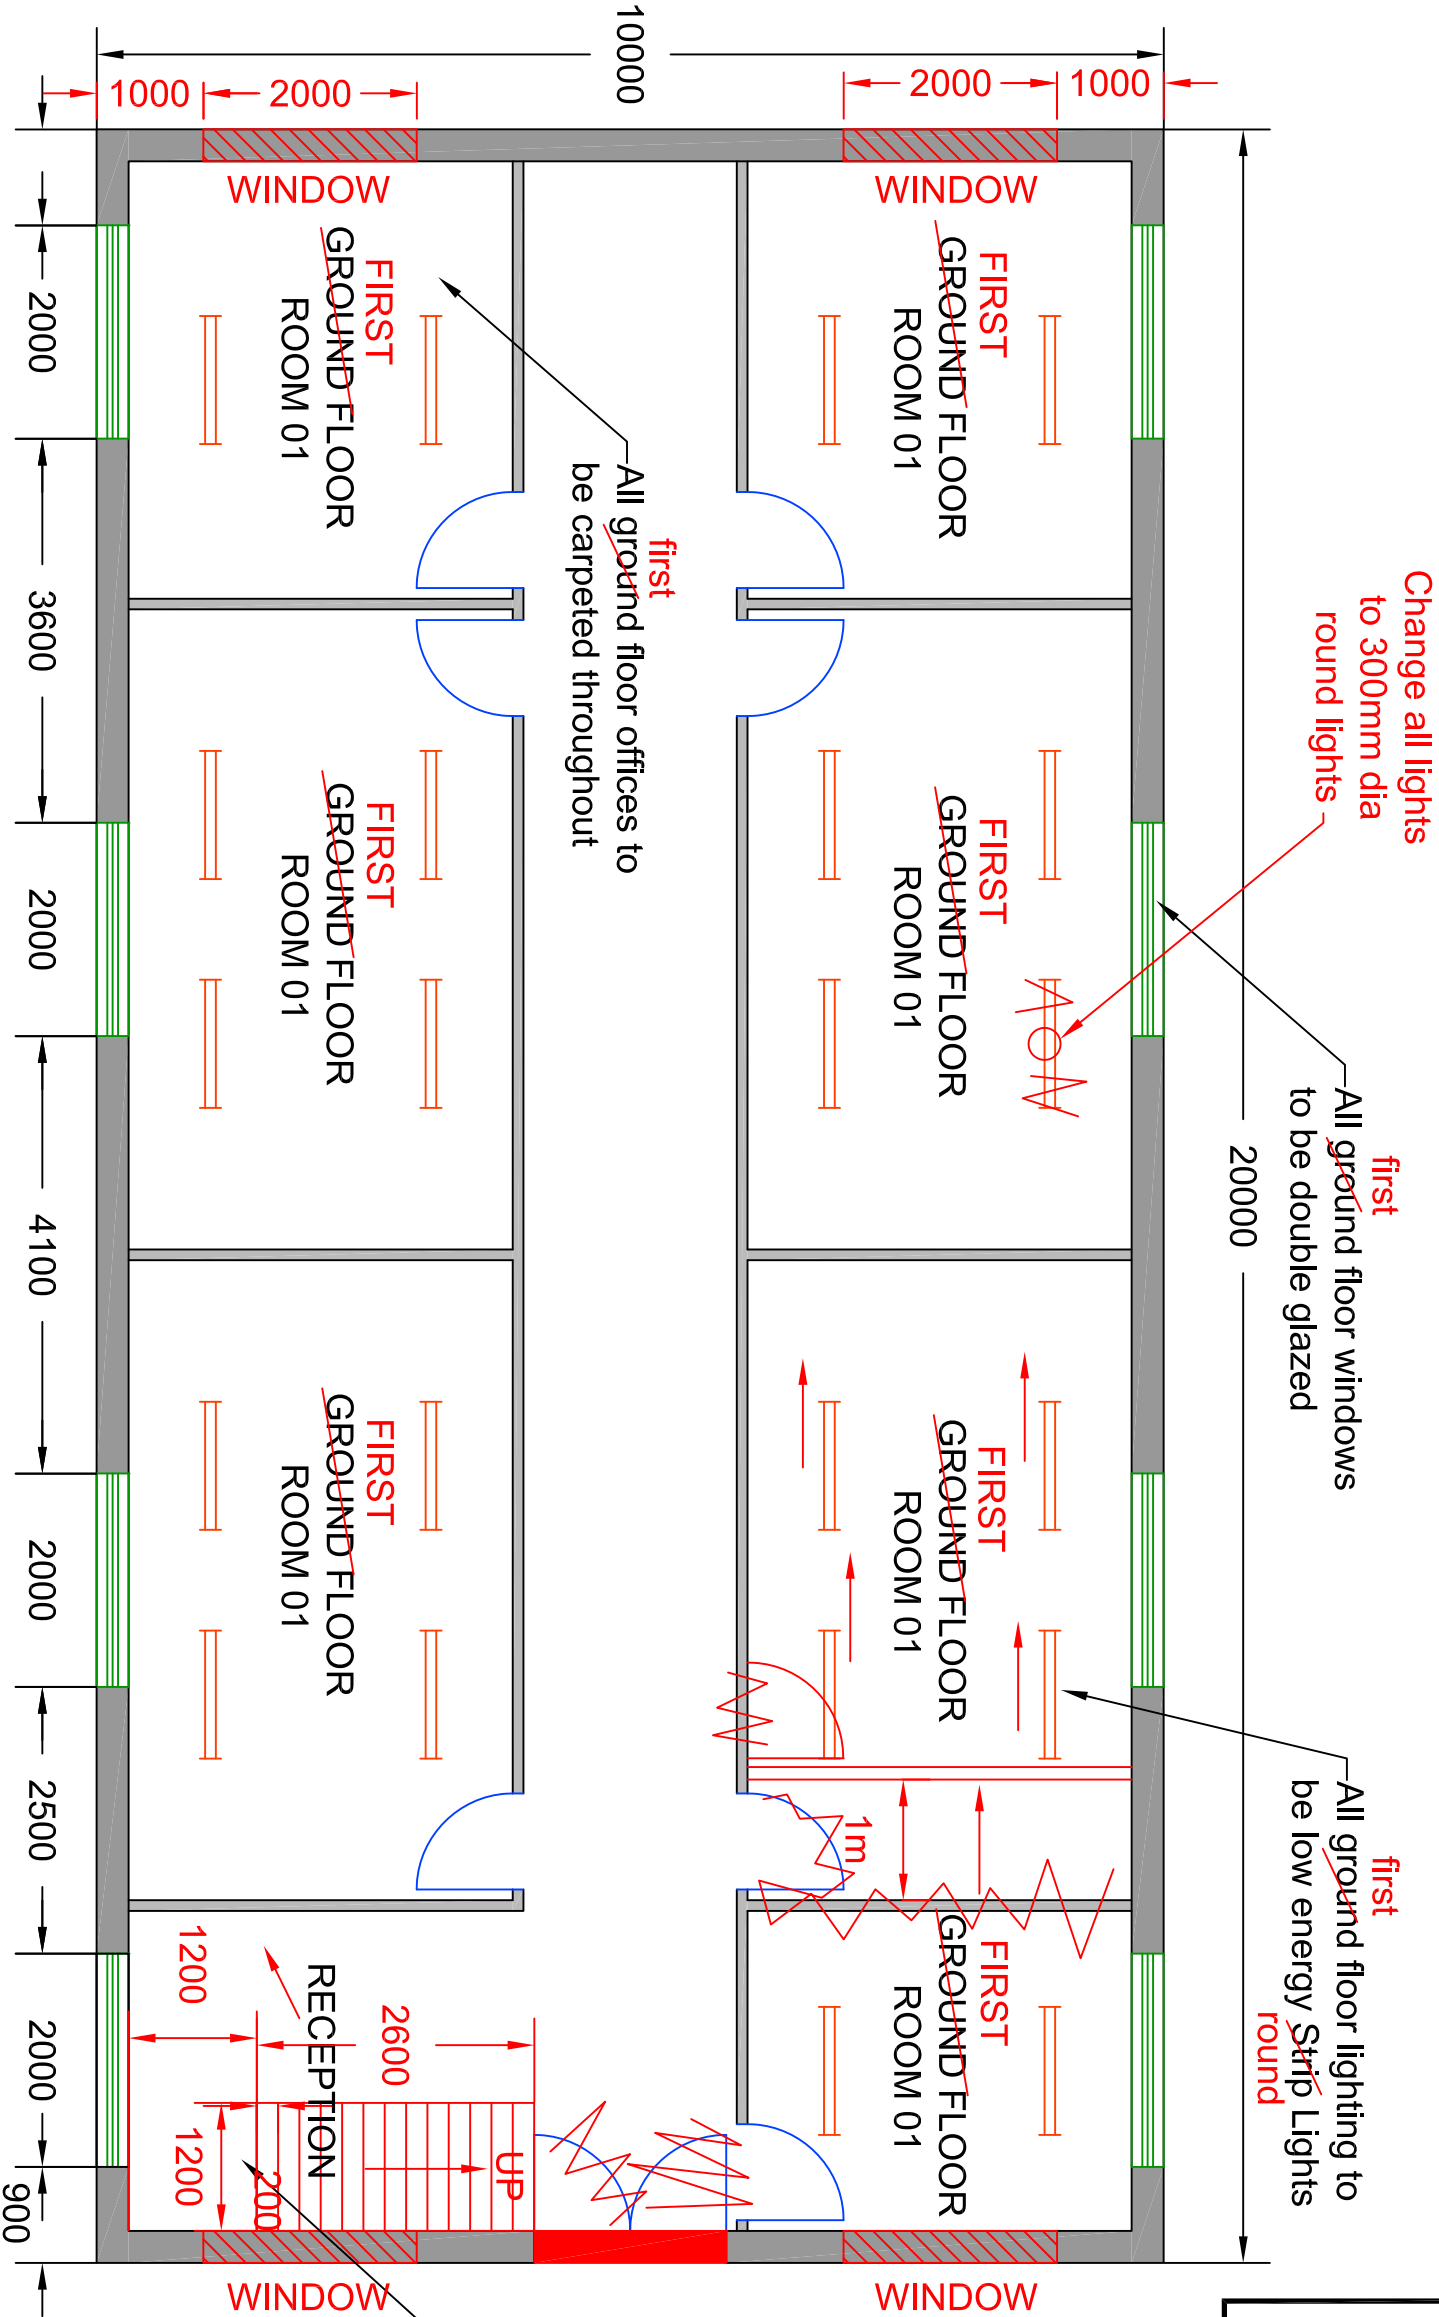

LEGEND

LIGHT FITTING

RADIATOR

AIR CON UNIT

LIGHT SWITCH

Reception to be fitted out as desired.

REV:	DESCRIPTION:	BY:	DATE:

PROJECT:	DRAWN BY:	DATE:	SCALE AT A0:
Proposed New Office Park Standard Office	MF	06/04/21	1:100
	CHECKED BY:	DATE:	REVISION:
	SF	06/04/21	1.0

TITLE:	DRAWING NO:
FIRST Ground Floor Layout	OPARK-BDG01-GF001

Aeroform 3D.com